



GOLV MODUL NR	101G	101G	101G	101G	101G	101G
TAK MODUL NR	101T	101T	101T	101T	101T	101T
VÄGG MODUL NR	101V, 102V	101V, 102V	101V, 102V	101V, 102V	101V, 102V	101V, 102V

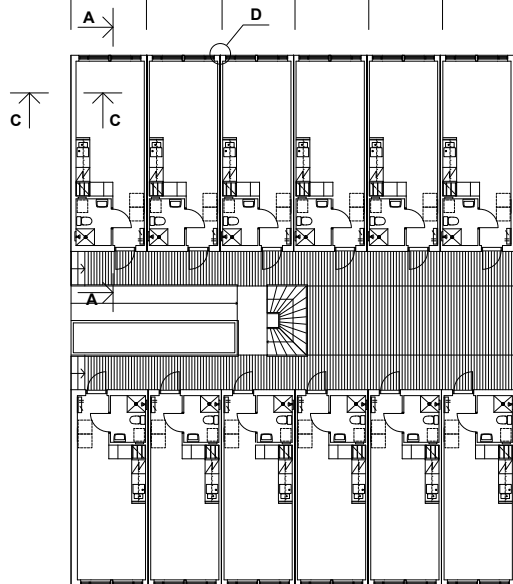

GOLV MODUL NR	101G	101G	101G	101G	101G	101G
TAK MODUL NR	101T	101T	101T	101T	101T	101T
VÄGG MODUL NR	101V,102V	101V,102V	101V,102V	101V,102V	101V,102V	101V,102V


BOTTENPLAN

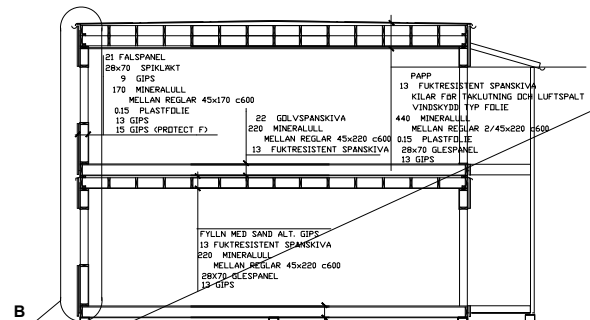

A-A
1:50


22 GOLVSPANSKIVA
220 MINERALULL
MELLAN REGLAR 45x220 c600
13 FUKTRESISTENT SPANSKIVA

GOLV MODUL NR	201G	201G	201G	201G	201G	201G
TAK MODUL NR	201T	201T	201T	201T	201T	201T
VÄGG MODUL NR	201V,201V	201V,201V	201V,201V	201V,201V	201V,201V	201V,201V

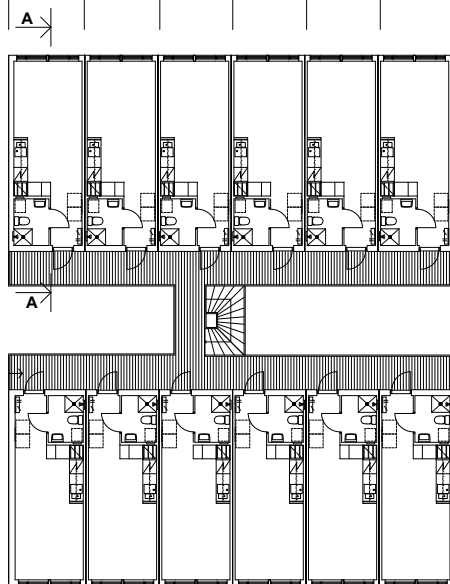


GOLV MODUL NR	201G	201G	201G	201G	201G	201G
TAK MODUL NR	201T	201T	201T	201T	201T	201T
VÄGG MODUL NR	201V,201V	201V,201V	201V,201V	201V,201V	201V,201V	201V,201V


PLAN 1 TR

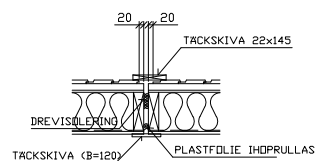

D
1:20

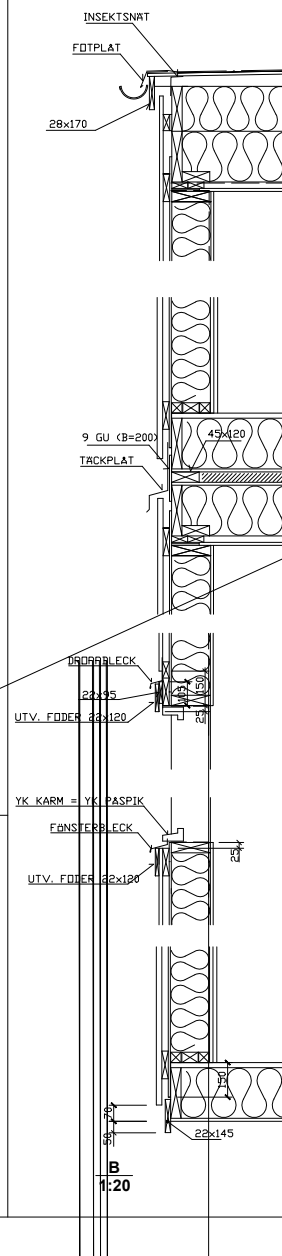

B
1:20

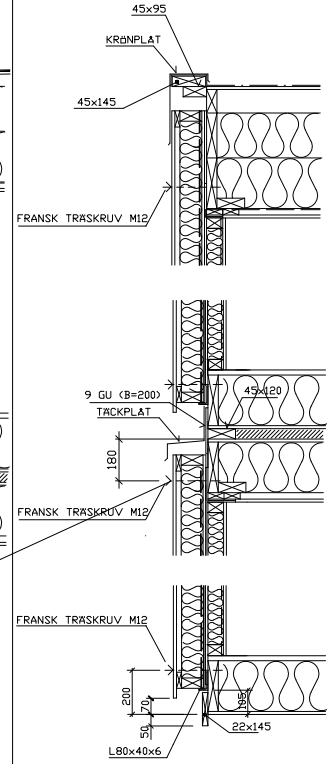

C-C
1:20

REF	ANT	REVISIONEN ANSER	SKALA	DATUM
RELATIONSHANDLING				
ARBETSNUMMER	RTAD AV	HANDLÄGGARE		
DATUM	ANSVARG			
SKALA	RITNINGNUMMER	REV		